

Amendments to the Drawings:

The attached twelve sheets of drawings include changes to Figures 1-8. The “Replacement Sheets” replace the original sheets of Figures 1-8. The “Annotated Sheets Showing Changes” are pen-and-ink sketches of Figures 1-8 showing the changes in red ink. The sheets are labeled accordingly and attached at page 12 as an Appendix to this Response.



RECEIVED
JUN 30 2004
Technology Center 2100

FORMAL DRAWINGS



FIG. 1

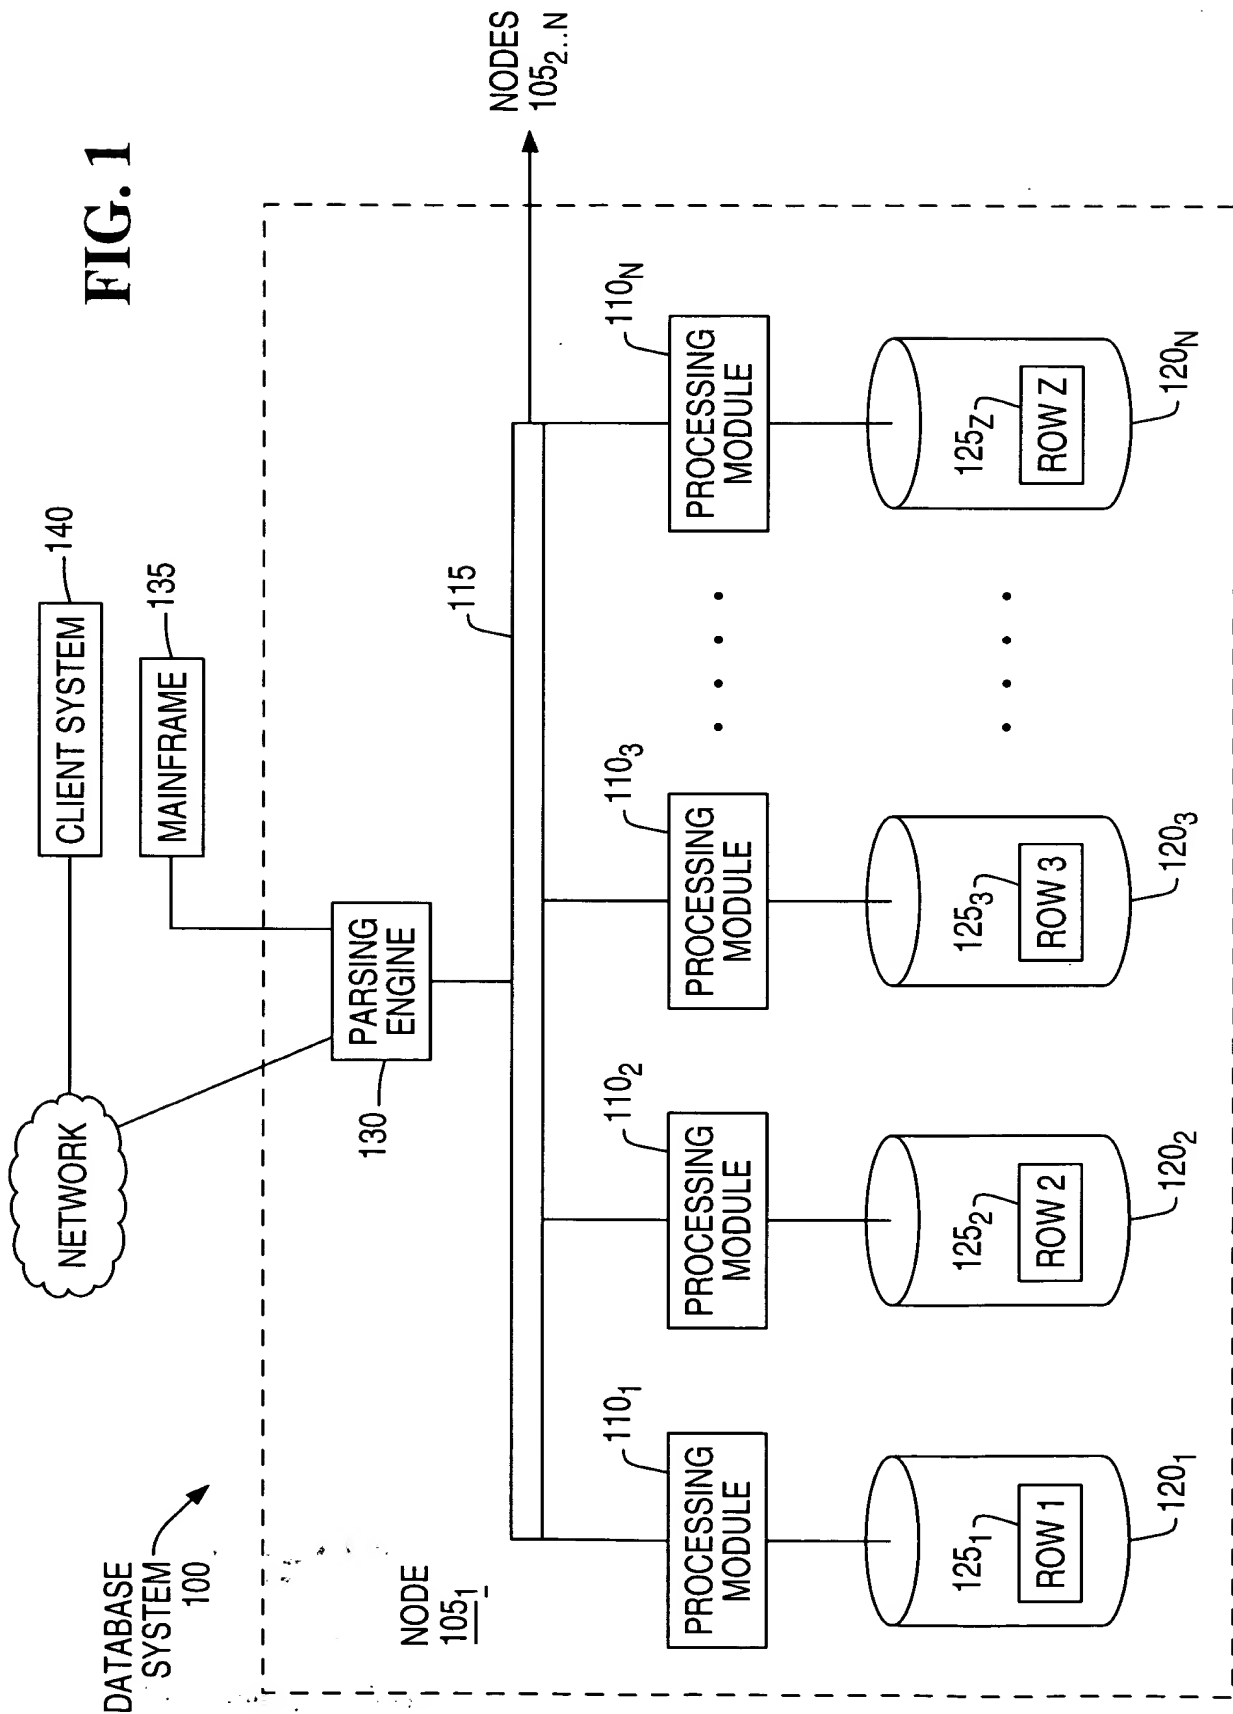




FIG. 2


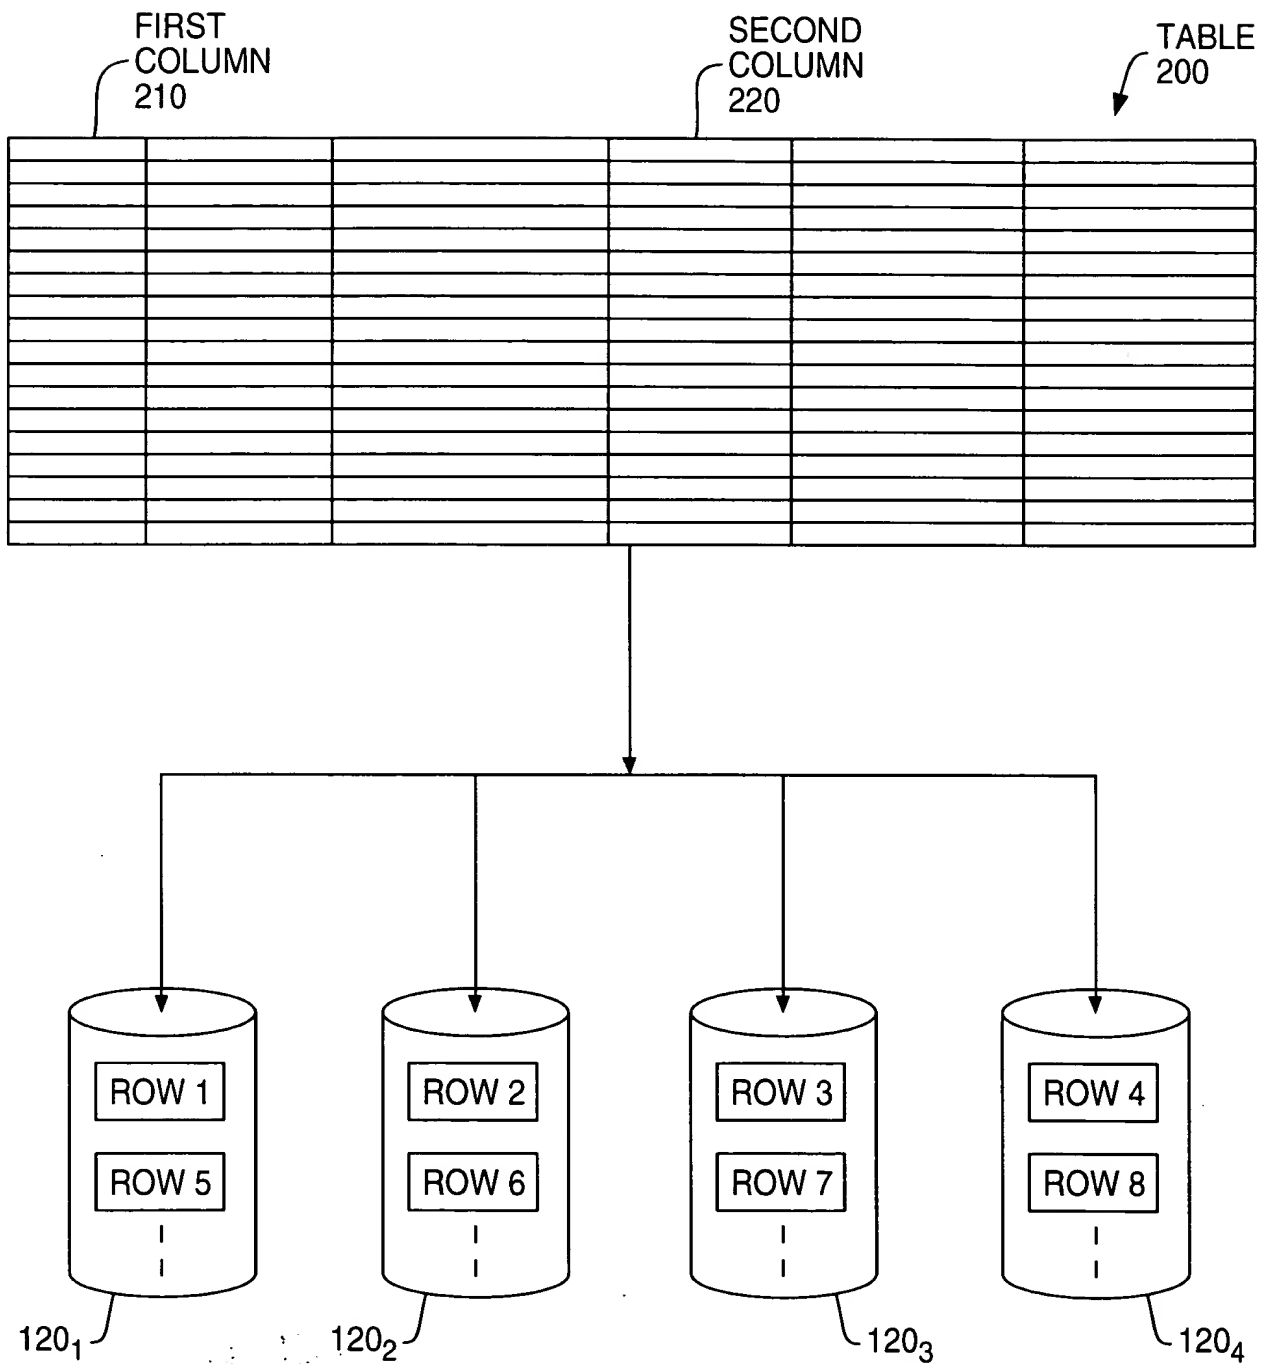




FIG. 3



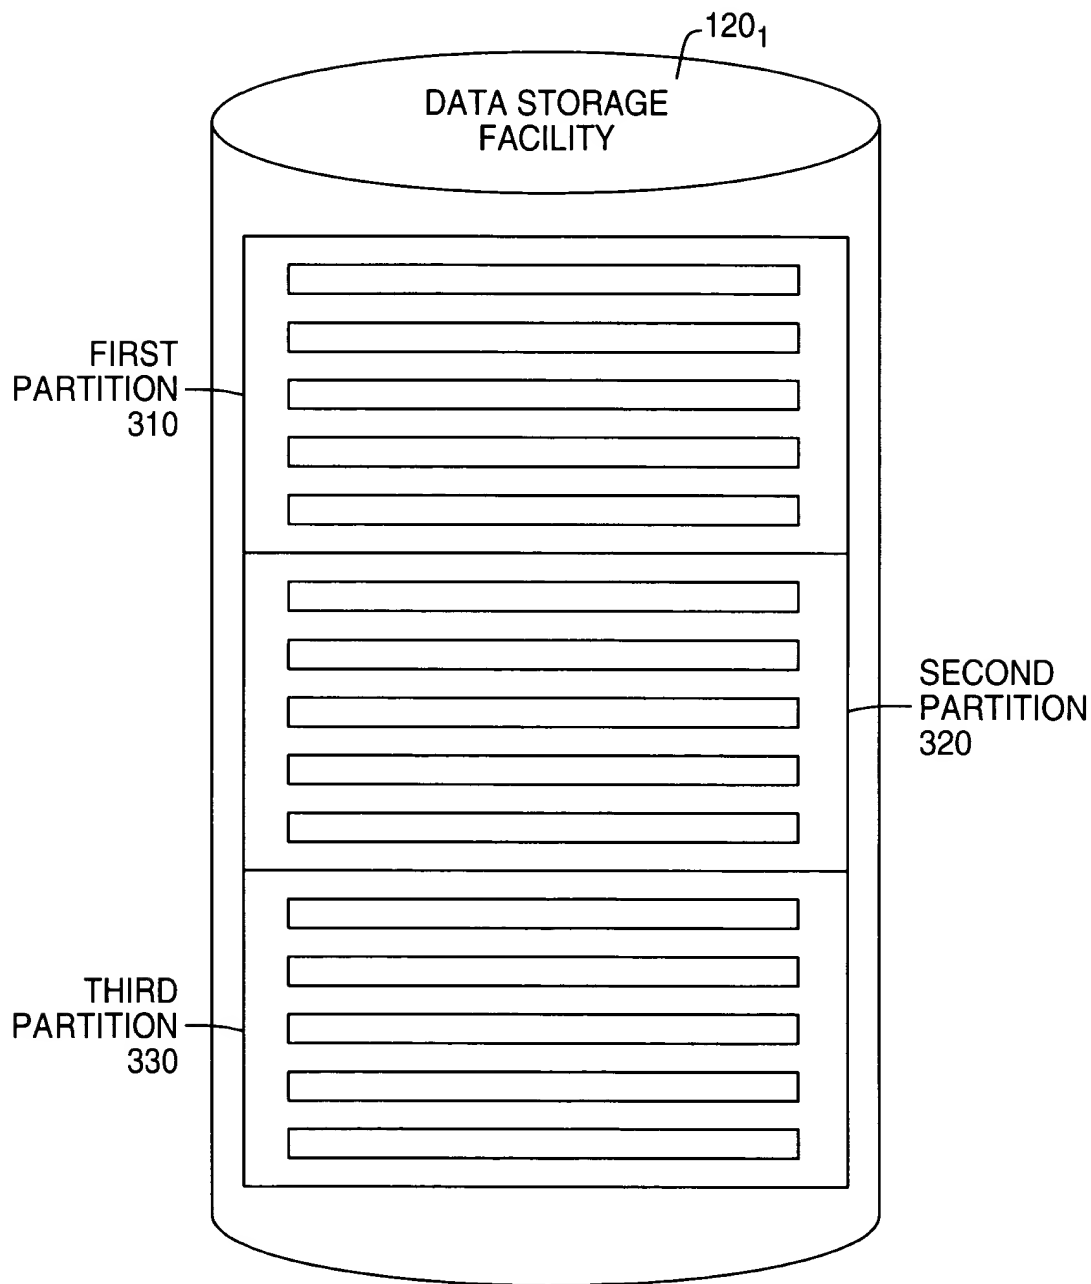

E.G., RANGES
OF DATES IN
A COLUMN

FIG. 4

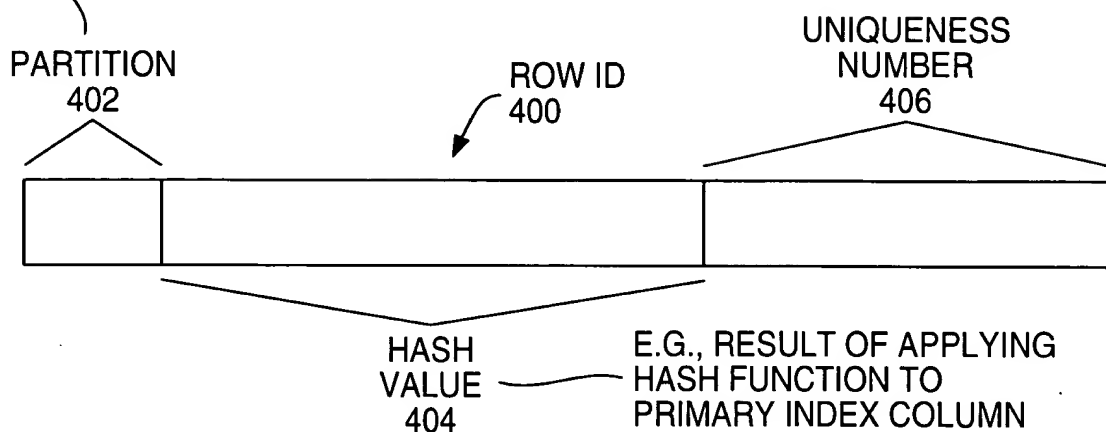


FIG. 5

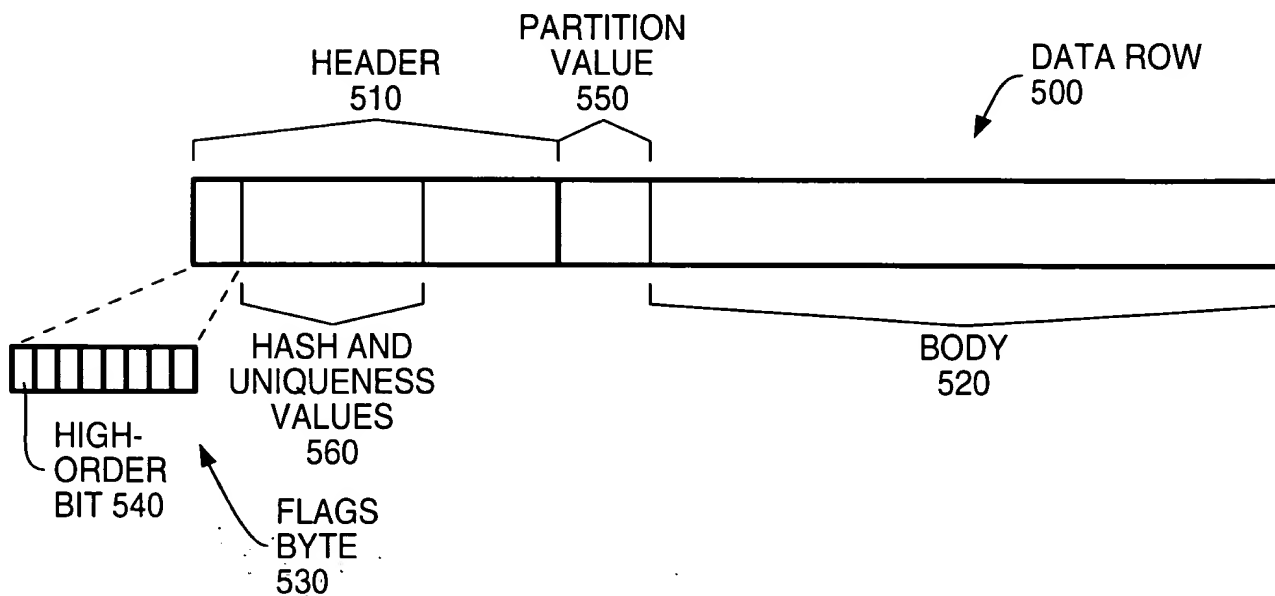




FIG. 6

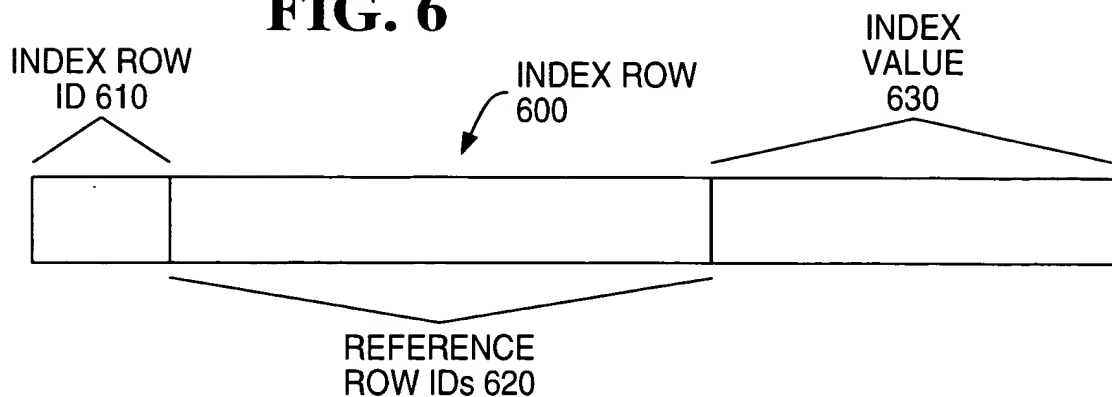


FIG. 7


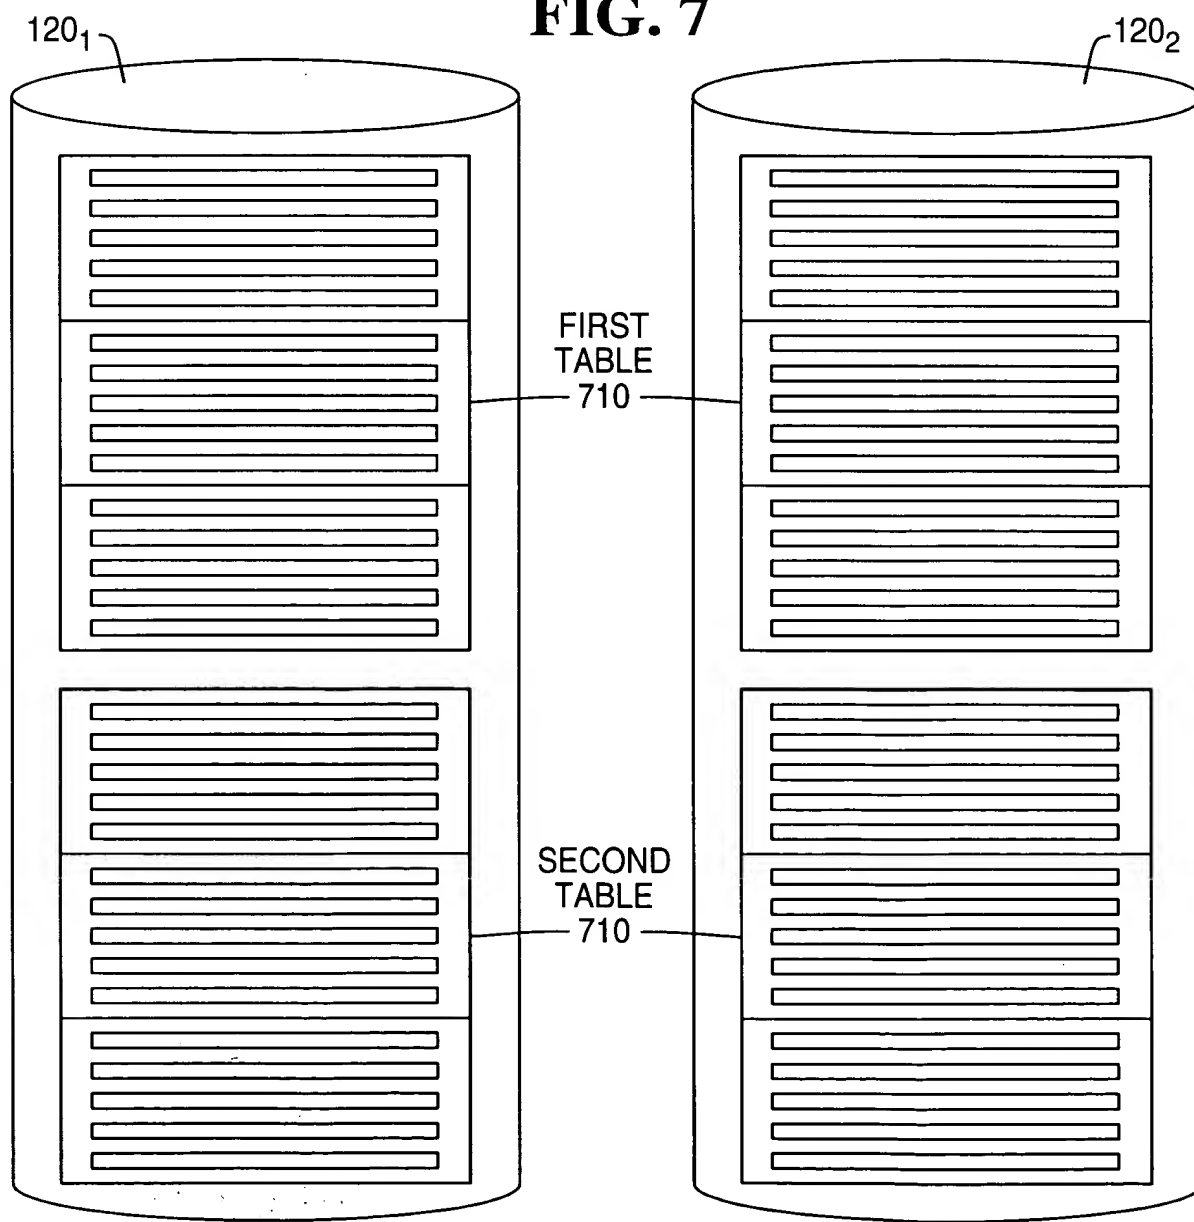




FIG. 8



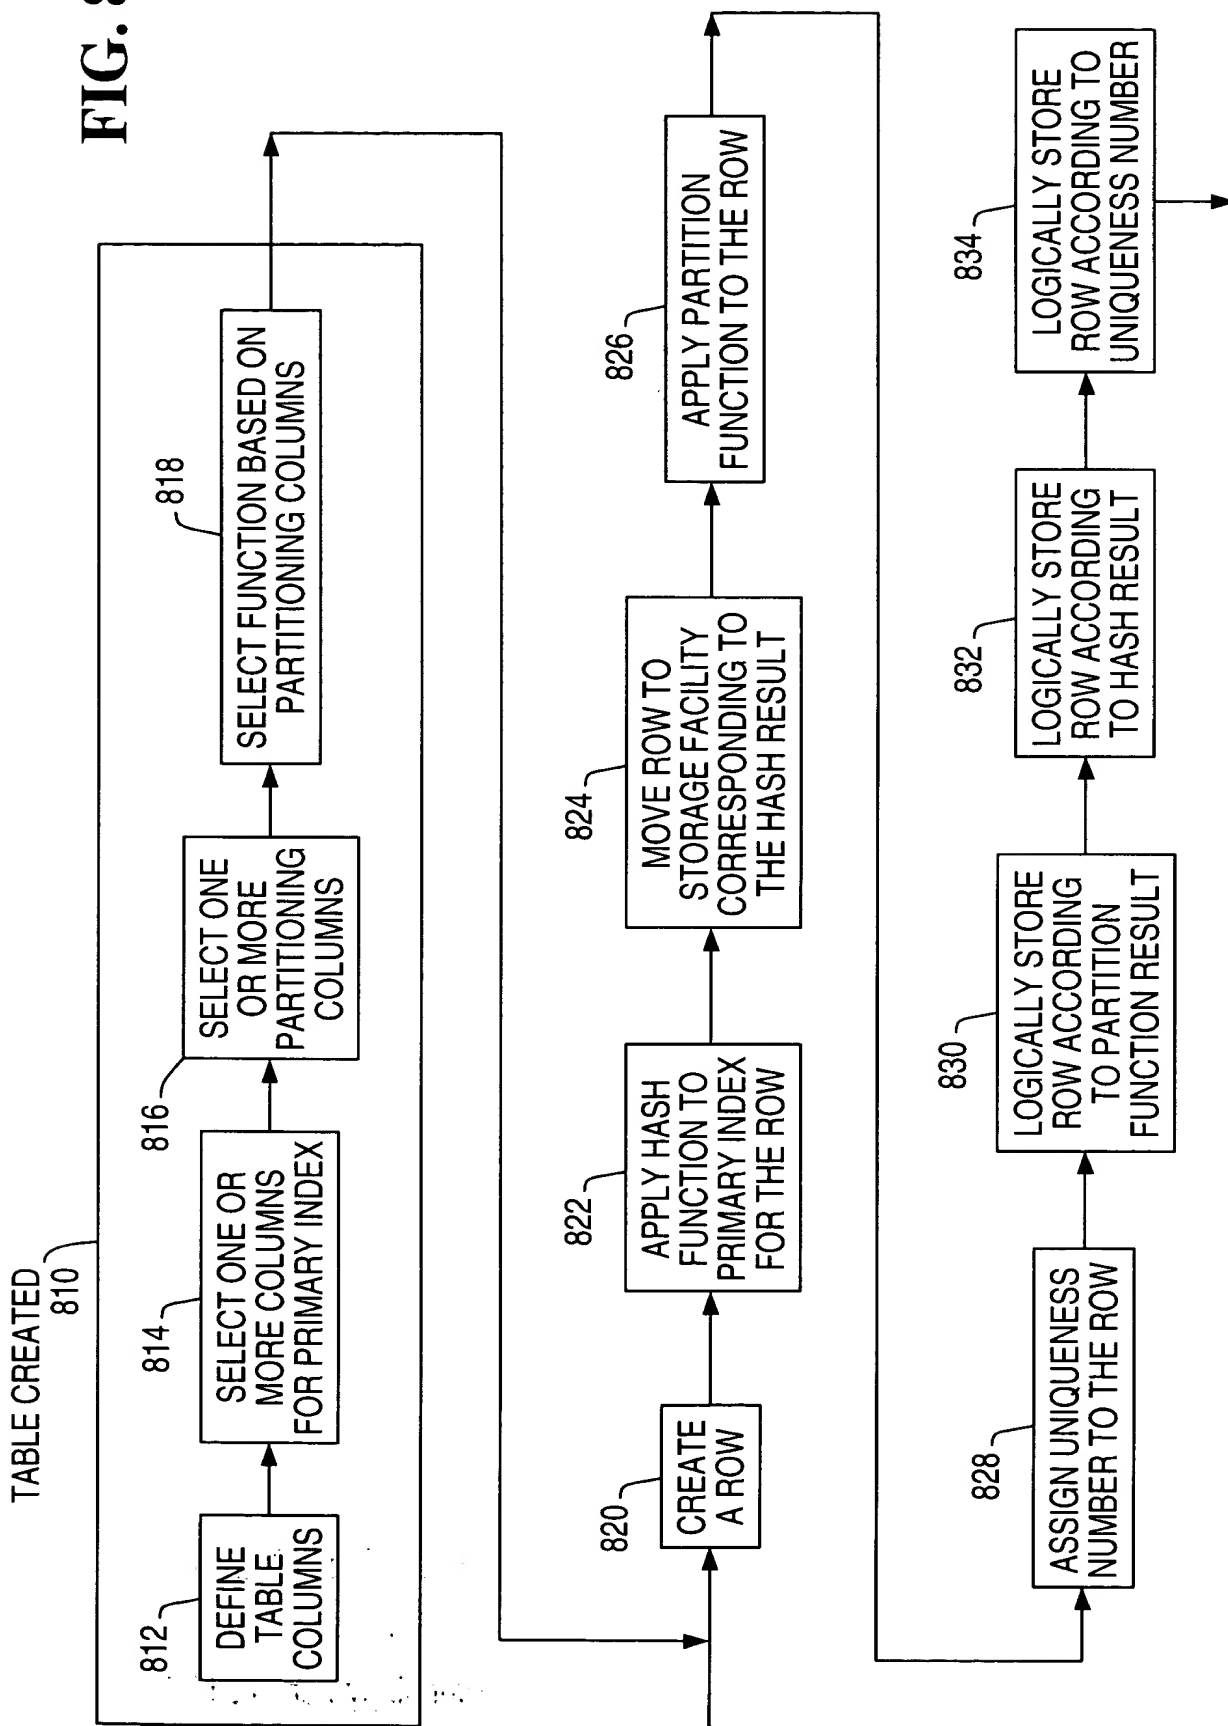

RECEIVED

JUN 30 2004

Technology Center 2100

REDLINE DRAWINGS



Title: Partitioned Database System
Inventor: P. L. Sinclair
U.S. Serial Number: 09/981,613

FIG. 1


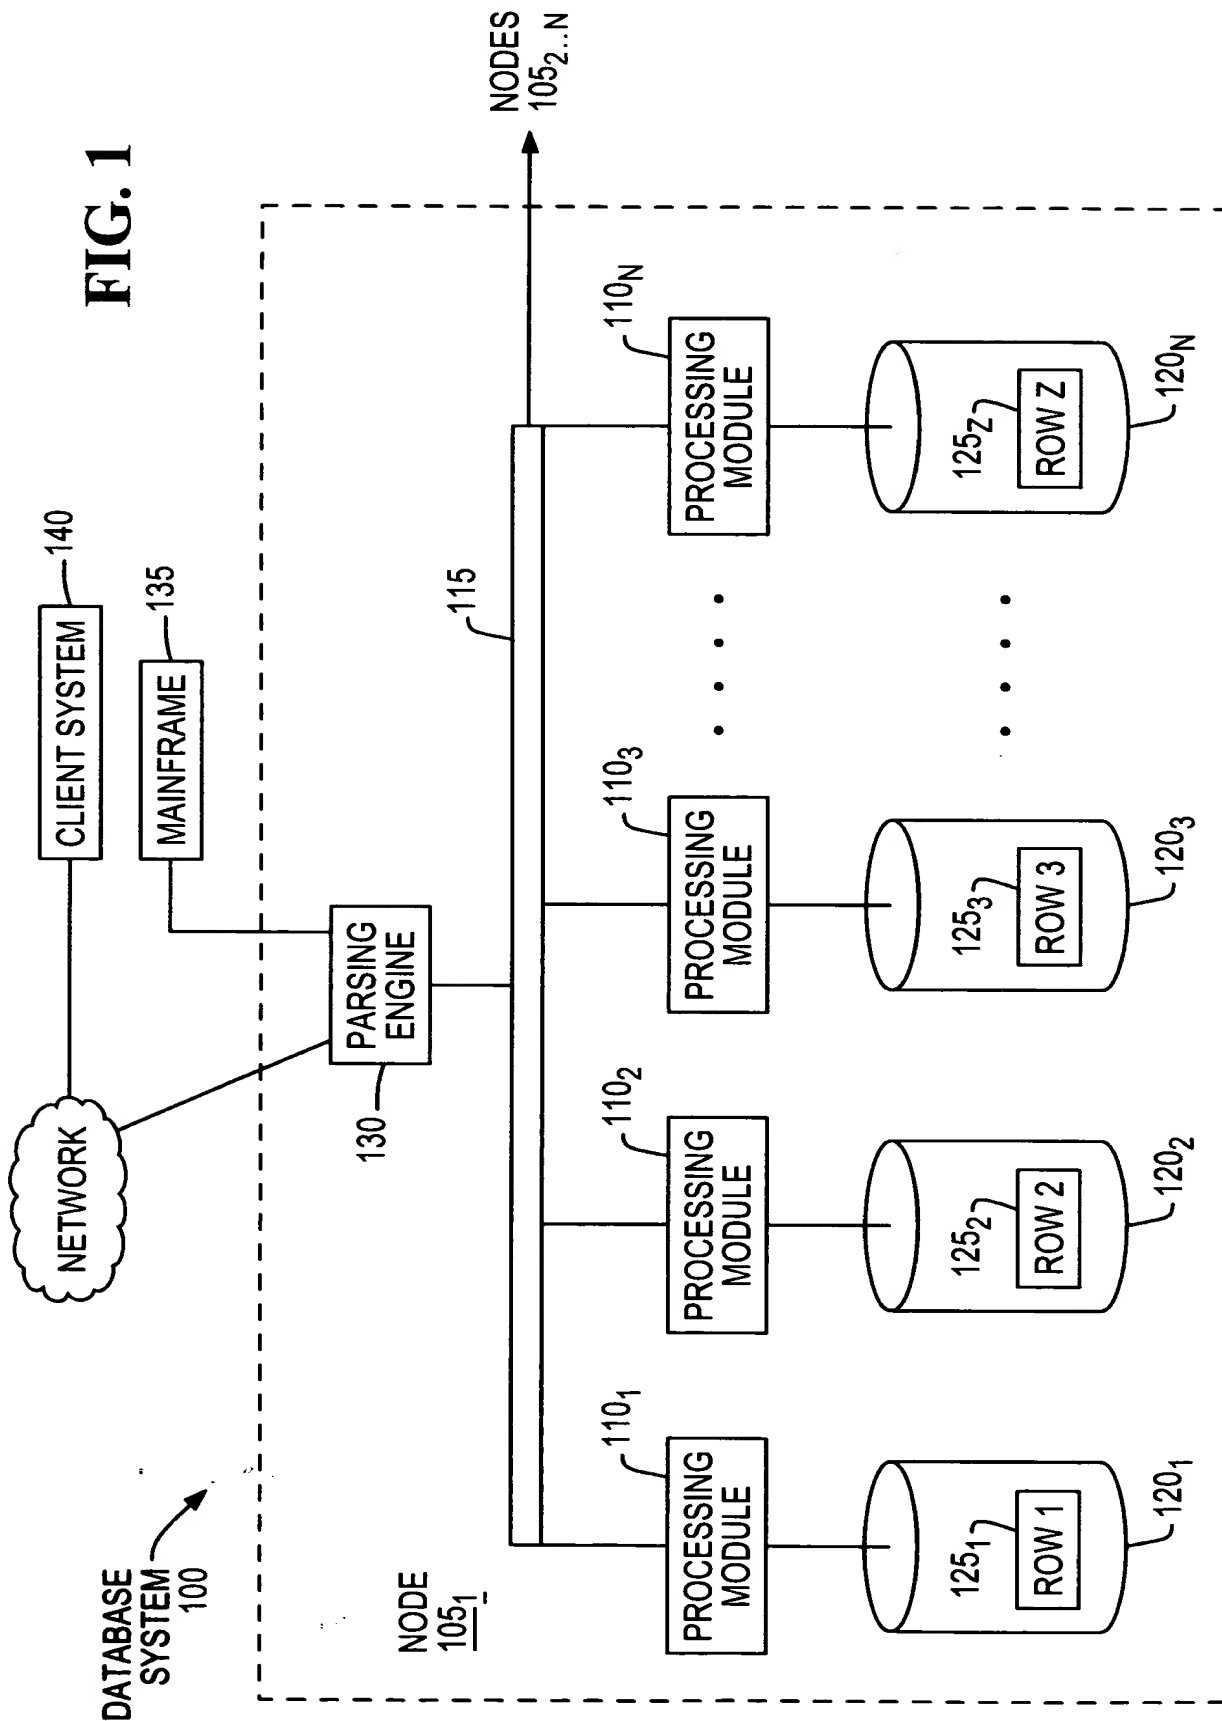





FIG. 2



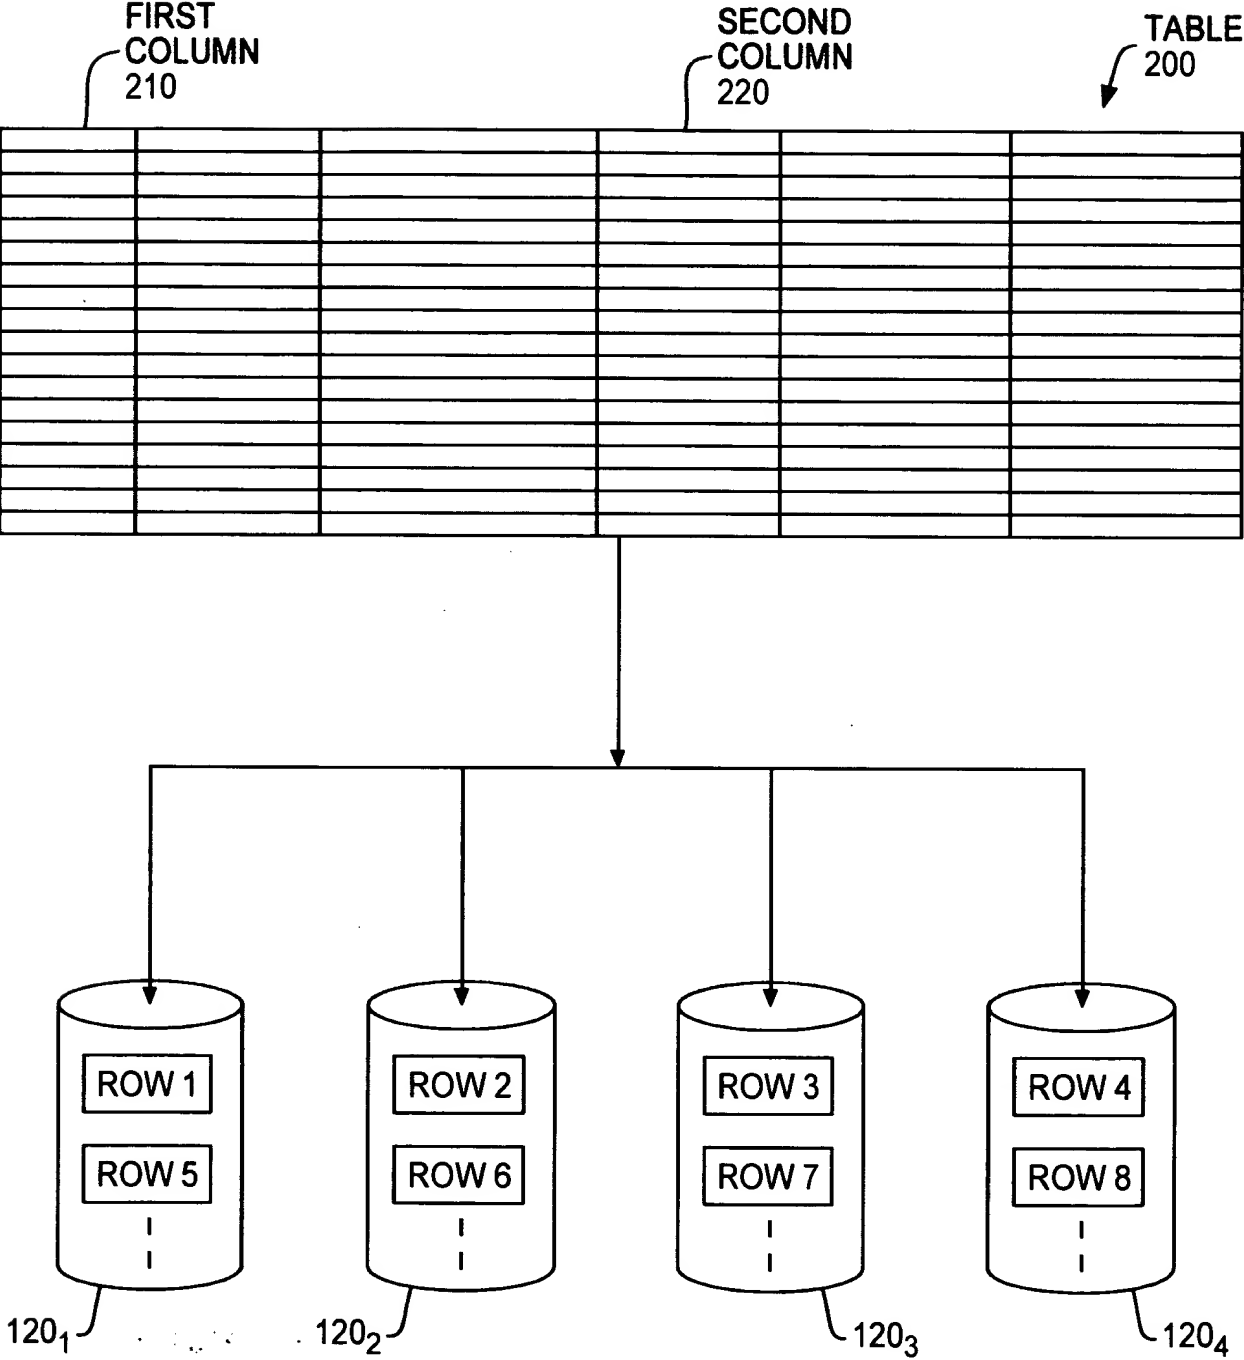

Title: Partitioned Database System
Inventor: P. L. Sinclair
U.S. Serial Number: 09/981,613

FIG. 3

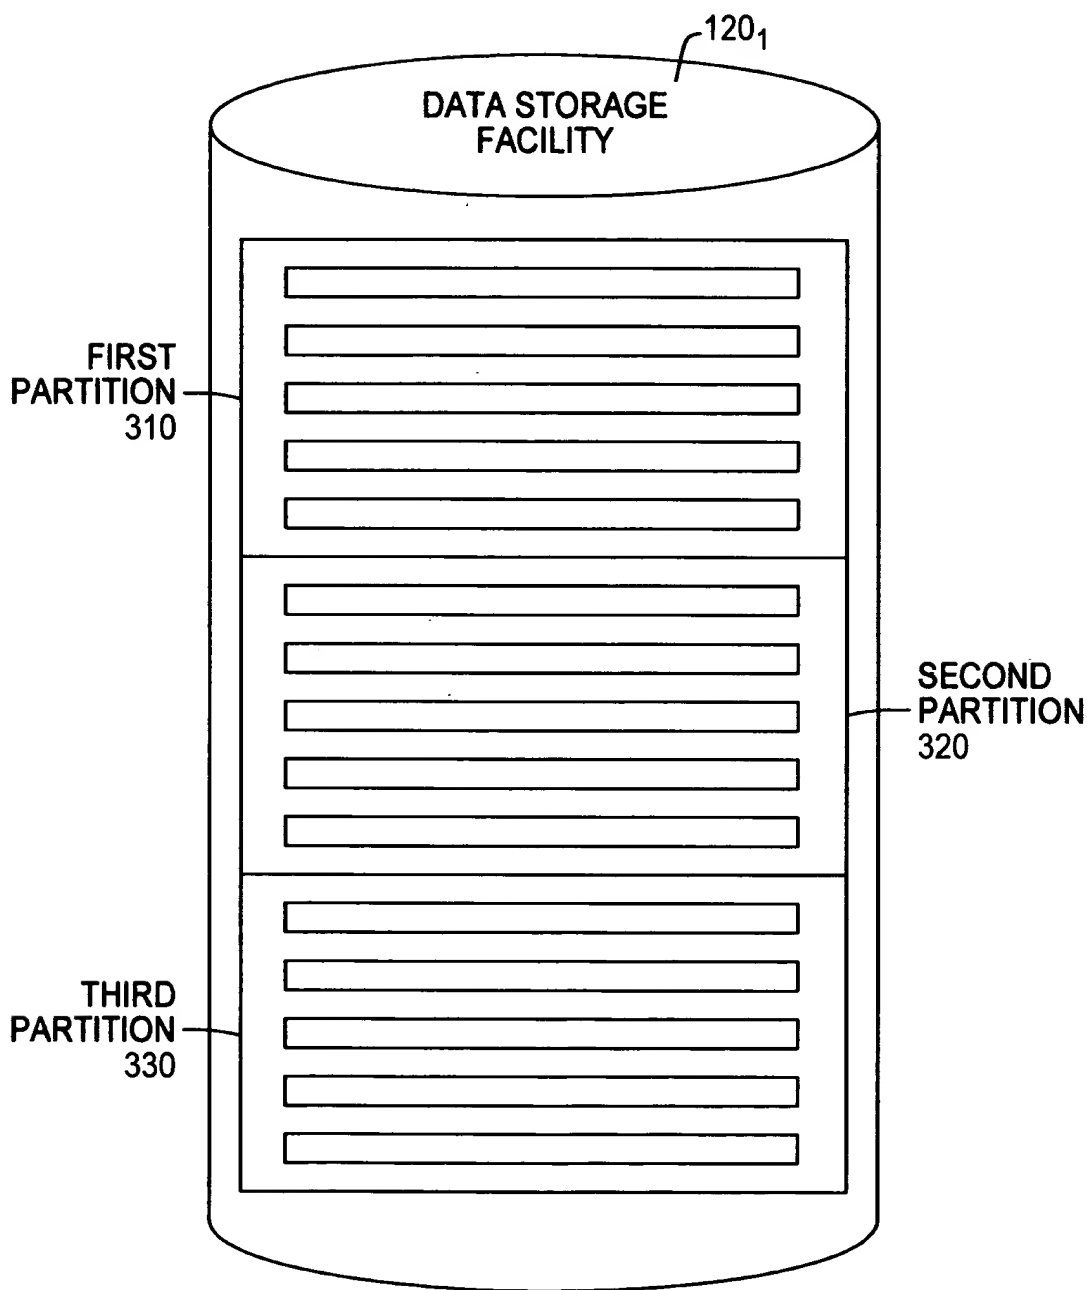



E.G., RANGES
OF DATES IN
A COLUMN

FIG. 4

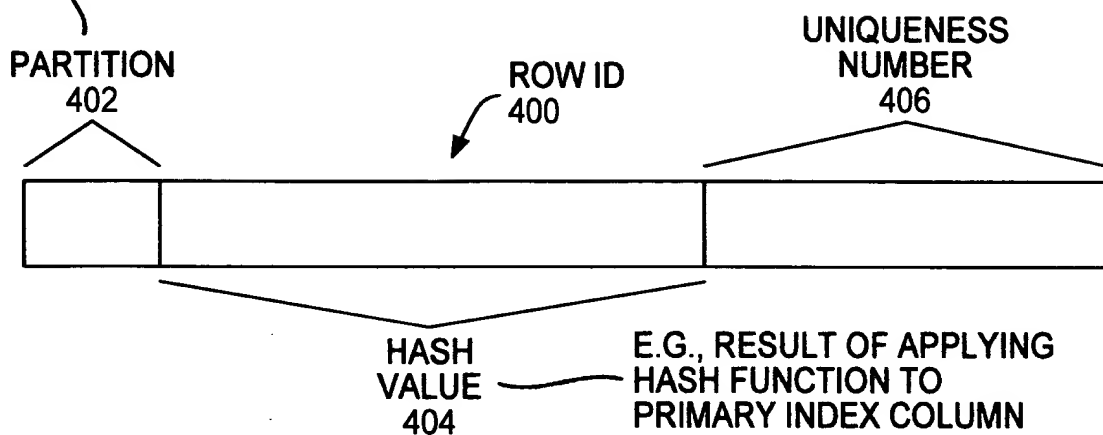


FIG. 5

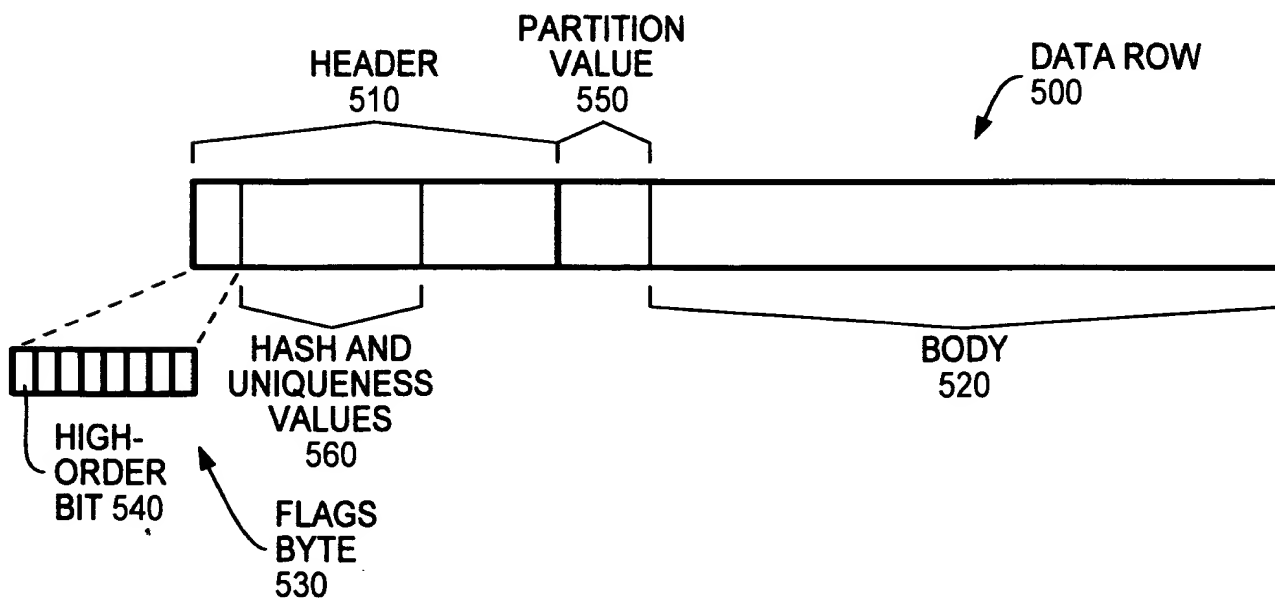




FIG. 6

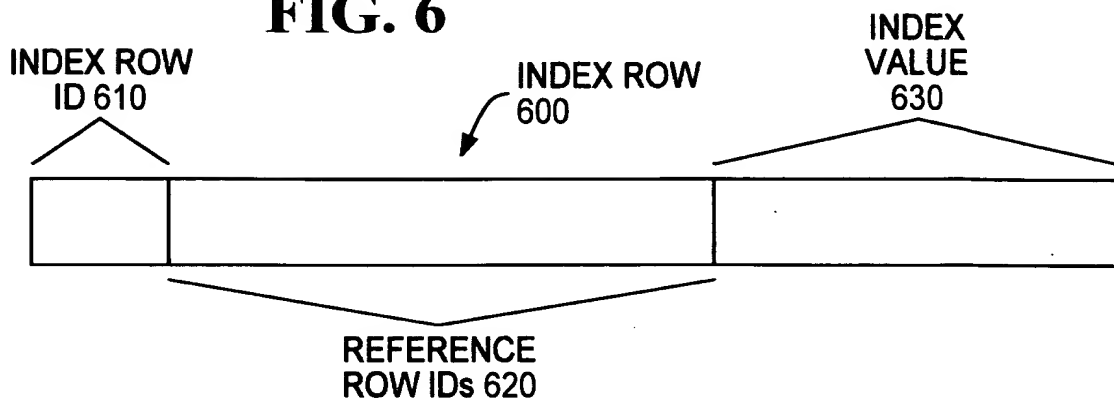


FIG. 7

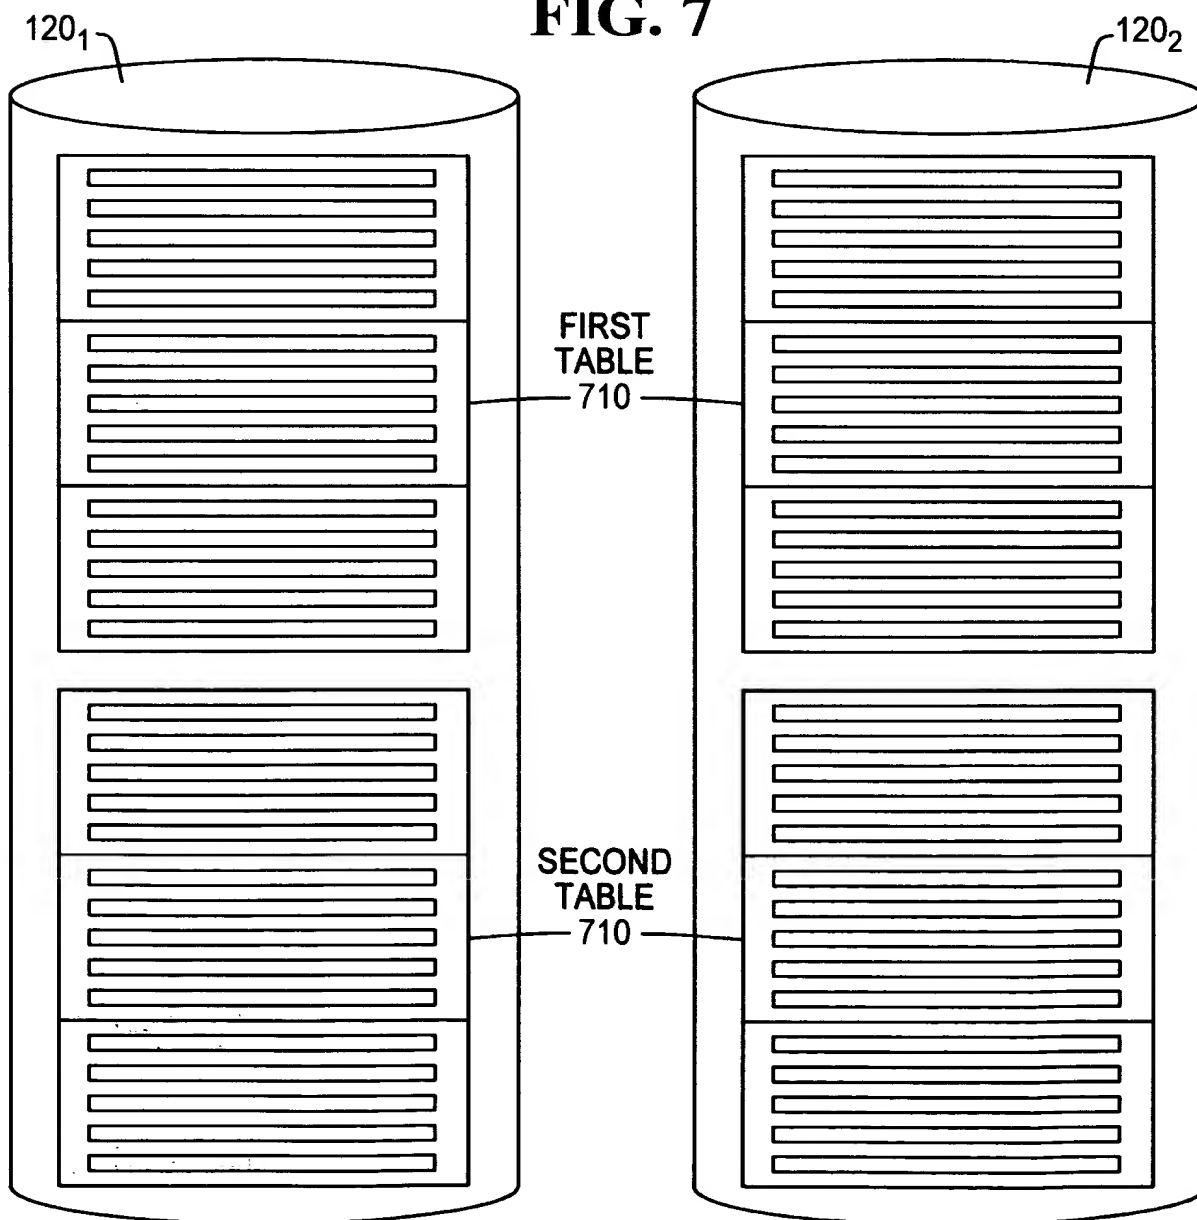


FIG. 8

